



KEY

	ETC S4 10° @ 750w
	ETC S4 19° @ 750w
	ETC S4 26° @ 750w
	ETC S4 36° @ 750w
	ETC S4 50° @ 750w
	ETC S4 ZM 15°-30° @ 750w
	ETC S4 ZM 25°-50° @ 750w
	MFL S4 PAR @ 575w
	COLORTRAN 2K FRESNEL @ 2kw
	CHAUVENT MK1 SPOT @ 592w
	CHAUVENT R1 BW @ 297w
	MARTIN RUSH PAR ZM @ 151w
	4 CELL CYC @ 4k
	LYCIAN FOLLOW SPOT
	HAZER

LEGEND

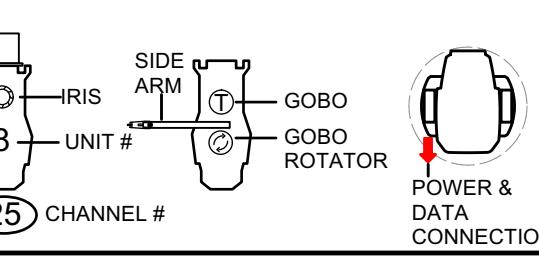


VER.	DATE	DESCRIPTION
1	12/9/23	SHOP PREP
2	12/29/23	REV. 1
3	01/03/24	REV. 2
4		

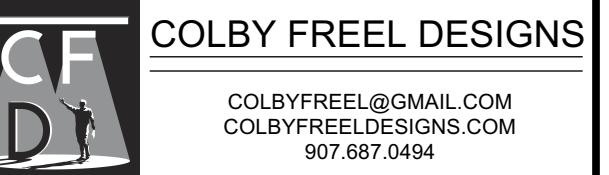

THIS DRAWING REPRESENTS VISUAL CONCEPTS AND CONSTRUCTION SUGGESTIONS ONLY


IT DOES NOT REPLACE THE KNOWLEDGE AND ADVICE OF A LICENSED STRUCTURAL OR ELECTRICAL ENGINEER. THE DESIGNER IS UNABLE TO DETERMINE THE SAFETY OR ELECTRICAL APPROPRIATENESS OF THIS DESIGN, AND WILL NOT ASSUME RESPONSIBILITY FOR IMPROPER ENGINEERING, CONSTRUCTION, HANDLING, OR USE OF EQUIPMENT.

PRODUCED BY:
LATHROP HIGH SCHOOL
DIRECTOR:
TJ HOVIST
MUSICAL DIRECTOR:
SUNNIVA DEEHR
SCENERY BY:
KAY GUZZETTA
COSTUME BY:
JAY PAGGI-HOWE
LIGHTING BY:
COLBY FREEL
ASSOCIATE LD:
JOSHUA HEMING
PRODUCTION
ALEX GAGNE-HAWES

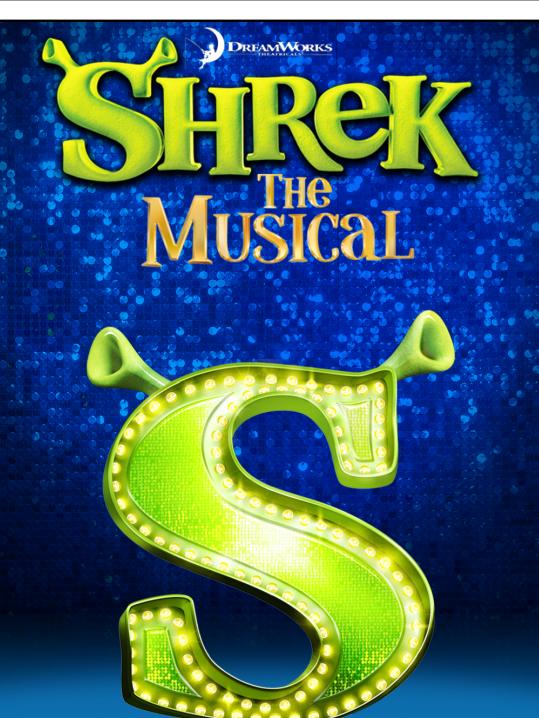

LIGHT PLOT


SCALE: 1/4" = 1'-0"	EXCEPT AS NOTED
DATE: 01/03/24	
DRAWN BY: cf	1 OF 3

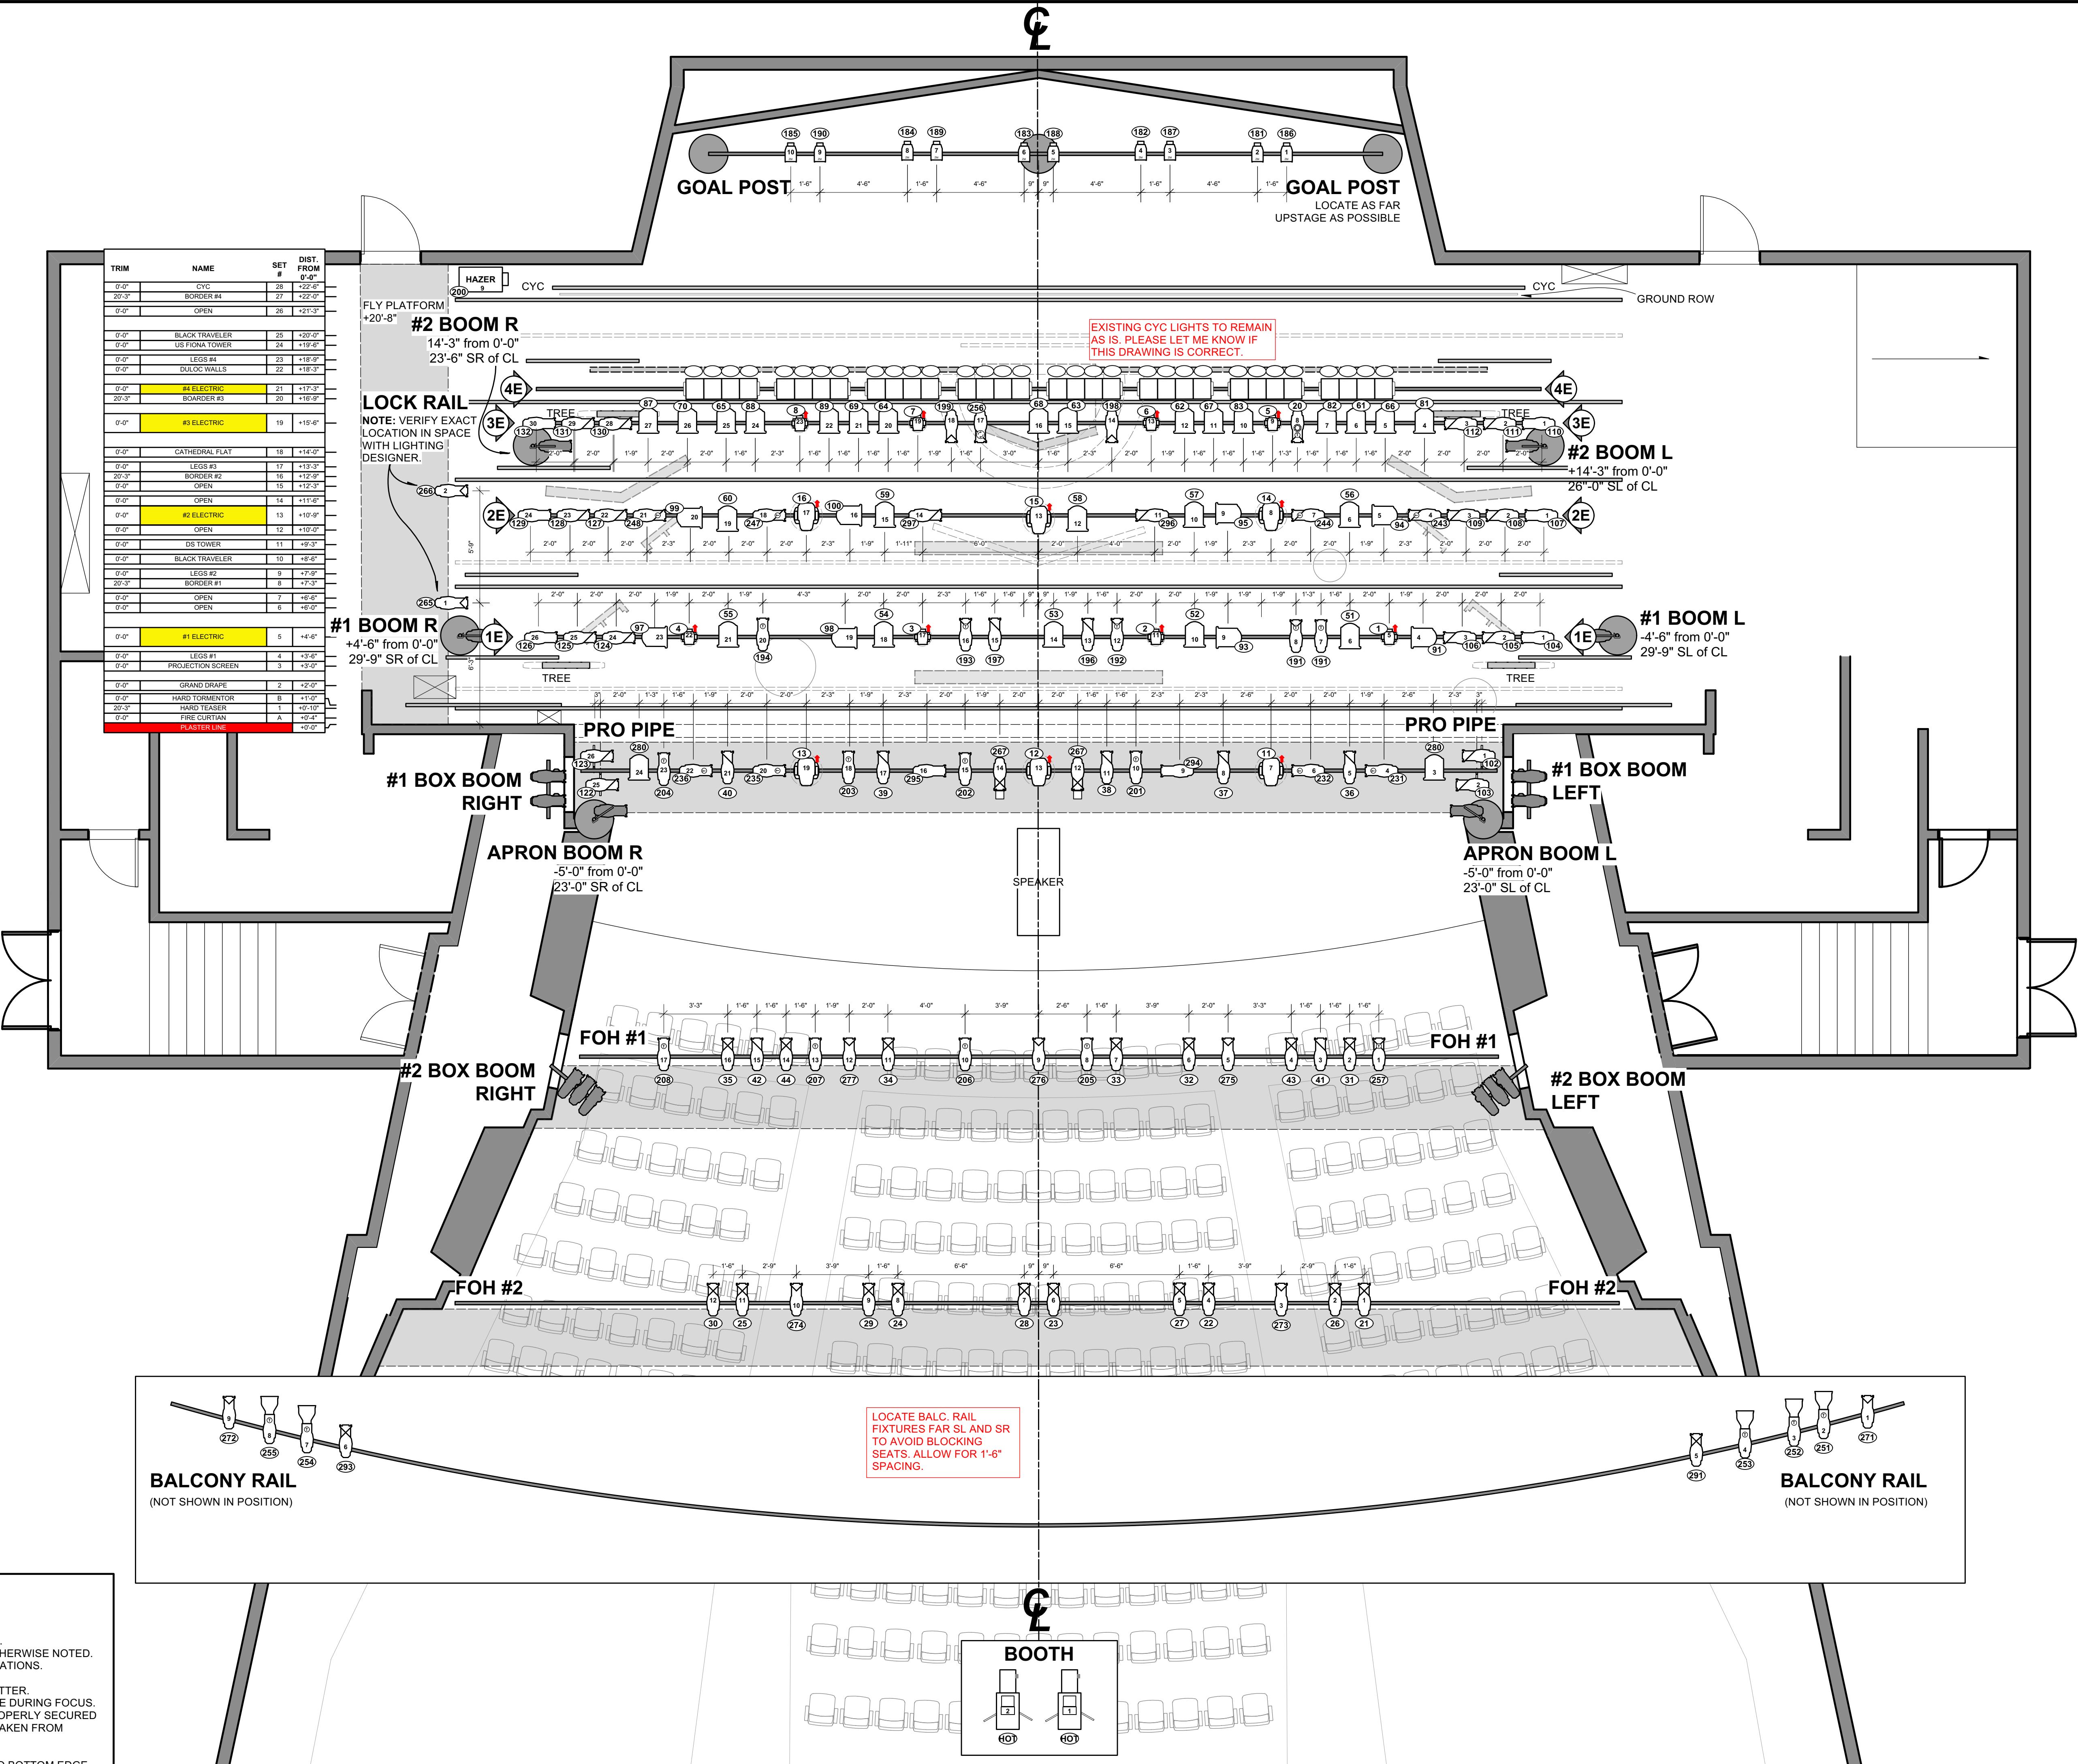

KEY

- ETC S4 10° @ 750w
- ETC S4 19° @ 750w
- ETC S4 26° @ 750w
- ETC S4 36° @ 750w
- ETC S4 50° @ 750w
- ETC S4 ZM 15°-30° @ 750w
- ETC S4 ZM 25°-50° @ 750w
- MFL S4 PAR @ 575w
- COLORTRAN 2K FRESNEL @ 2kw
- CHAUVT MK1 SPOT @ 592w
- CHAUVT R1 BW @ 297w
- MARTIN RUSH PAR ZM @ 151w
- 4 CELL CYC @ 4k
- LYCIAN FOLLOW SPOT
- HAZER

LEGEND

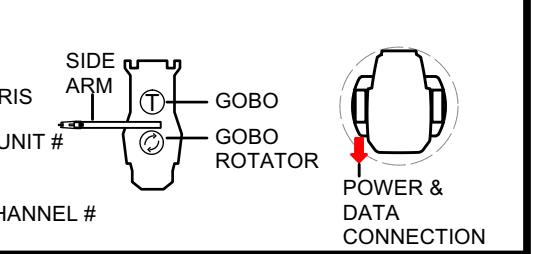


DRAWING SCHEDULE		
VER.	DATE	DESCRIPTION
1	12/9/23	SHOP PREP
2	12/29/23	REV. 1
3	01/03/24	REV. 2
4		



THIS DRAWING REPRESENTS VISUAL CONCEPTS AND CONSTRUCTION SUGGESTIONS ONLY


IT DOES NOT REPLACE THE KNOWLEDGE AND ADVICE OF A LICENSED STRUCTURAL OR ELECTRICAL ENGINEER. THE DESIGNER IS UNABLE TO VERIFY THE SAFETY AND ELECTRICAL APPROPRIATENESS OF THIS DESIGN, AND WILL NOT ASSUME RESPONSIBILITY FOR IMPROPER ENGINEERING, CONSTRUCTION, HANDLING, OR USE OF EQUIPMENT.

PRODUCED BY:
LATHROP HIGH SCHOOL
DIRECTOR: T.J. HOVIST
MUSICAL DIRECTOR: SUNNIVA DEEHR
SCENERY BY: KAT GUZZETTA
COSTUME BY: JAY PAGGI-HOWE
LIGHTING BY: COLBY FREEL
ASSOCIATE LD: JOSHUA HEMING
PRODUCTION ELECTRICIAN: ALEX GAGNE-HAWES

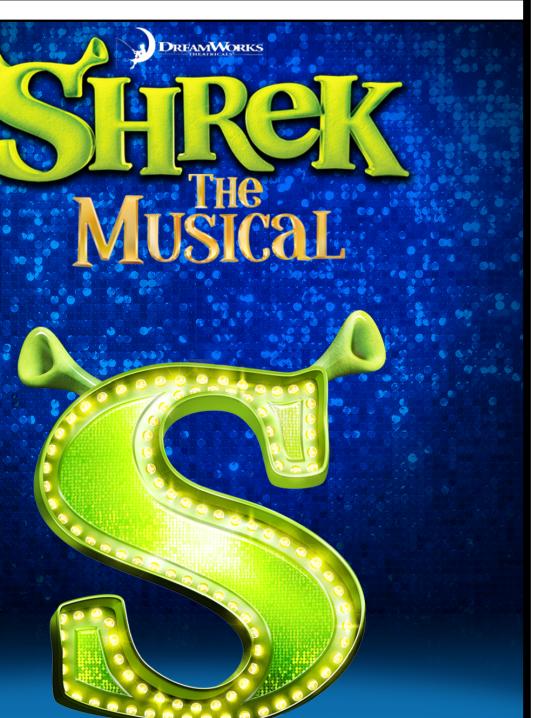

SECTION

SCALE: 1/4" = 1'-0"	EXCEPT AS NOTED
DATE: 01/03/24	
DRAWN BY: cf	2 OF 3

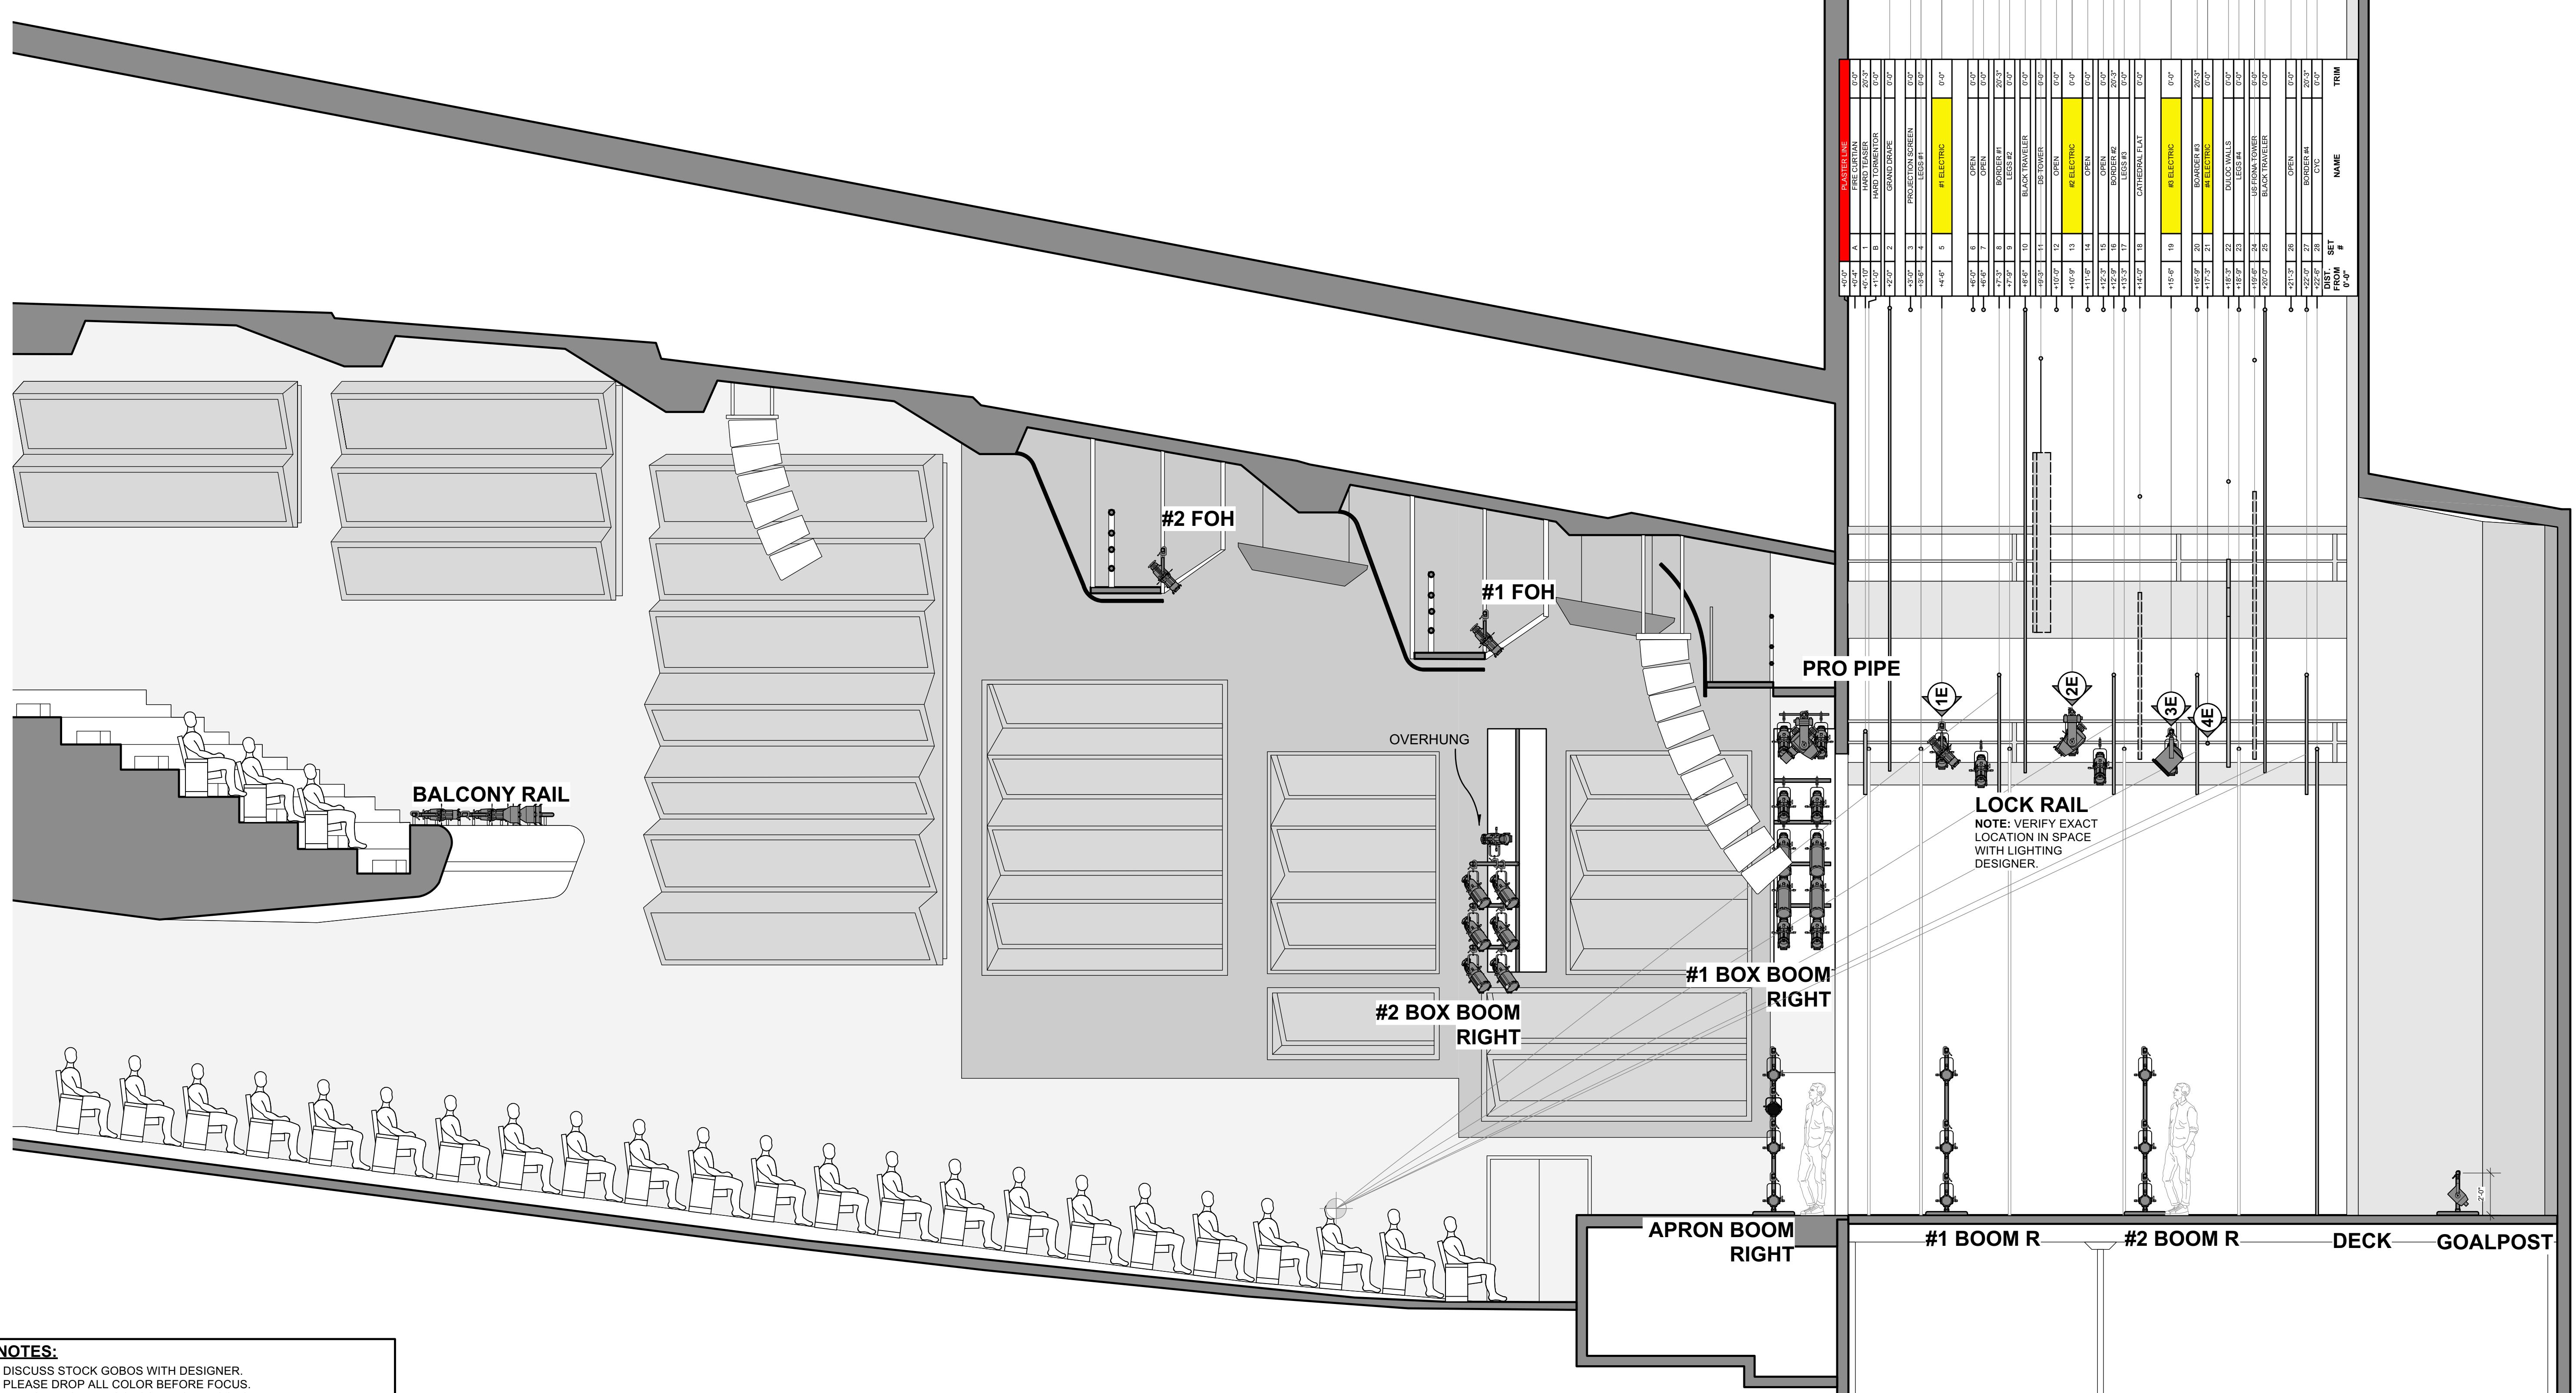

NOTES:


- DISCUSS STOCK GOBOS WITH DESIGNER.
- PLEASE DROP ALL COLOR BEFORE FOCUS.
- PLEASE DROP ALL GOBOS BEFORE FOCUS.
- PLEASE FLASH OUT ALL UNITS BEFORE FOCUS.
- ALL UNITS HANG ON 1" CENTERS, UNLESS OTHERWISE NOTED.
- PLEASE PROVIDE SPARE CIRCUITS IN ALL LOCATIONS.
- DISCUSS SCUTTER MOUNTS TO LOCK RAIL.
- PLEASE PRE-FOCUS ALL UNITS SHARP TO SHUTTER.
- PLEASE PROVIDE EXTRA R110 TO BE AVAILABLE DURING FOCUS.
- ALL BOOMS TO BE PLACED AS DRAWN AND PROPERLY SECURED AND COUNTERWEIGHTED. BOOM DIMENSIONS TAKEN FROM INTERSECTION OF THE P.L. AND C.L.
- ELECTRIM TRIMS TAKEN FROM DECK TO PIPE.
- BORDER/TEASER TRIMS TAKEN FROM DECK TO BOTTOM EDGE OF BORDER/TRIM.

KEY

	ETC S4 10° @ 750w
	ETC S4 19° @ 750w
	ETC S4 26° @ 750w
	ETC S4 36° @ 750w
	ETC S4 50° @ 750w
	ETC S4 ZM 15°-30° @ 750w
	ETC S4 ZM 25°-50° @ 750w
	MFL S4 PAR @ 575w @ 2kw
	COLORTRAN 2K FRESNEL @ 2kw
	CHAUVENT MK1 SPOT @ 592w
	CHAUVENT R1 BW @ 297w
	MARTIN RUSH PAR ZM @ 151w
	4 CELL CYC @ 4K
	LYCIAN FOLLOW SPOT
	HAZER

NOTE:
- USE SIDE ARMS AT BOOMS IF POSSIBLE.
- DIMENSIONS ARE TAKEN TO HARDWARE, NOT TO FIXTURE.

LEGEND

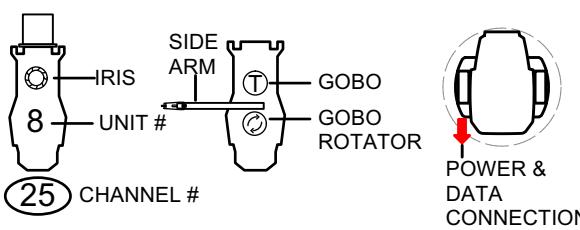


DRAWING SCHEDULE		
VER.	DATE	DESCRIPTION
1	12/9/23	SHOP PREP
2	12/29/23	REV. 1
3	01/03/24	REV. 2
4		

COLBY FREEL DESIGNS
COLBYFREEL@GMAIL.COM
COLBYFREELDESIGNS.COM
907.687.0494

THIS DRAWING REPRESENTS VISUAL CONCEPTS AND CONSTRUCTION SUGGESTIONS ONLY

IT DOES NOT REPLACE THE KNOWLEDGE AND ADVICE OF A LICENSED STRUCTURAL OR ELECTRICAL ENGINEER. THE DESIGNER IS UNABLE TO DETERMINE THE STRUCTURAL OR ELECTRICAL APPROPRIATENESS OF THIS DESIGN, AND WILL NOT ASSUME RESPONSIBILITY FOR IMPROPER ENGINEERING, CONSTRUCTION, HANDLING, OR USE OF EQUIPMENT.

PRODUCED BY:
LATHROP HIGH SCHOOL
DIRECTOR: T.J. HOVIST
MUSICAL DIRECTOR: SUNNIVA DEEHR
SCENERY BY: KAT GUZZETTA
COSTUME BY: JAY PAGGI-HOWE
LIGHTING BY: COLBY FREL
ASSOCIATE LD: JOSHUA HEMING
PRODUCTION: ALEX GAGNE-HAWES

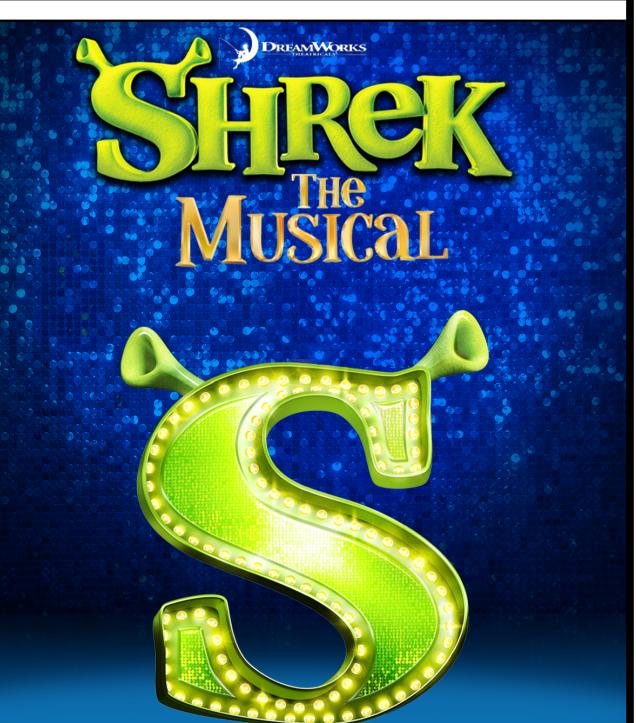

VERTICALS

SCALE: 1/4" = 1'-0"	EXCEPT AS NOTED
DATE: 01/03/24	
DRAWN BY: cf	3 OF 3

NOTES:

- DISCUSS STOCK GOBOS WITH DESIGNER.
- PLEASE DROP ALL COLOR BEFORE FOCUS.
- PLEASE DROP ALL GOBOS BEFORE FOCUS.
- PLEASE FLASH OUT ALL UNITS BEFORE FOCUS.
- ALL UNITS HANG ON 1" CENTERS UNLESS OTHERWISE NOTED.
- PLEASE PROVIDE SPARE CIRCUITS AND PLUG LOCATIONS.
- DISCUSS SCUTTER MOUNTING TO LOCK RAIL.
- PLEASE PRE-FOCUS ALL UNITS SHARP TO SHUTTER.
- PLEASE PROVIDE EXTRA R110 TO BE AVAILABLE DURING FOCUS.
- ALL UNITS TO BE PLACED AS DRAWN AND PROPERLY SECURED AND COUNTERWEIGHTED. BOOM DIMENSIONS TAKEN FROM INTERSECTION OF THE P.L. AND C.L.
- ELECTRIM TRIMS TAKEN FROM DECK TO PIPE.
- BORDER/TEASER TRIMS TAKEN FROM DECK TO BOTTOM EDGE OF BORDER/TRIM.